

Seal

NOT FOR CONSTRUCTION

Consultants:

**POPLAR PLAZA
 RESTAURANT SPACE**


3482 PLAZA AVENUE
 MEMPHIS, TN 38111

Revisions:


© 2021 UrbanARCH Associates, P.C.
 No part of this work covered by the copyright hereon may be reproduced or copied in any form or by any means (graphic, electronic, mechanical, or photocopying) without the express written permission of UrbanARCH Associates, P.C. The use of these documents without the express written permission of UrbanARCH Associates, P.C. is illegal and a violation of federal copyright laws.

Project No: 21040
 Issued For: AS-BUILT COND.
 Date: 08.02.2021

AS-BUILT
 FLOOR PLANS
A-110

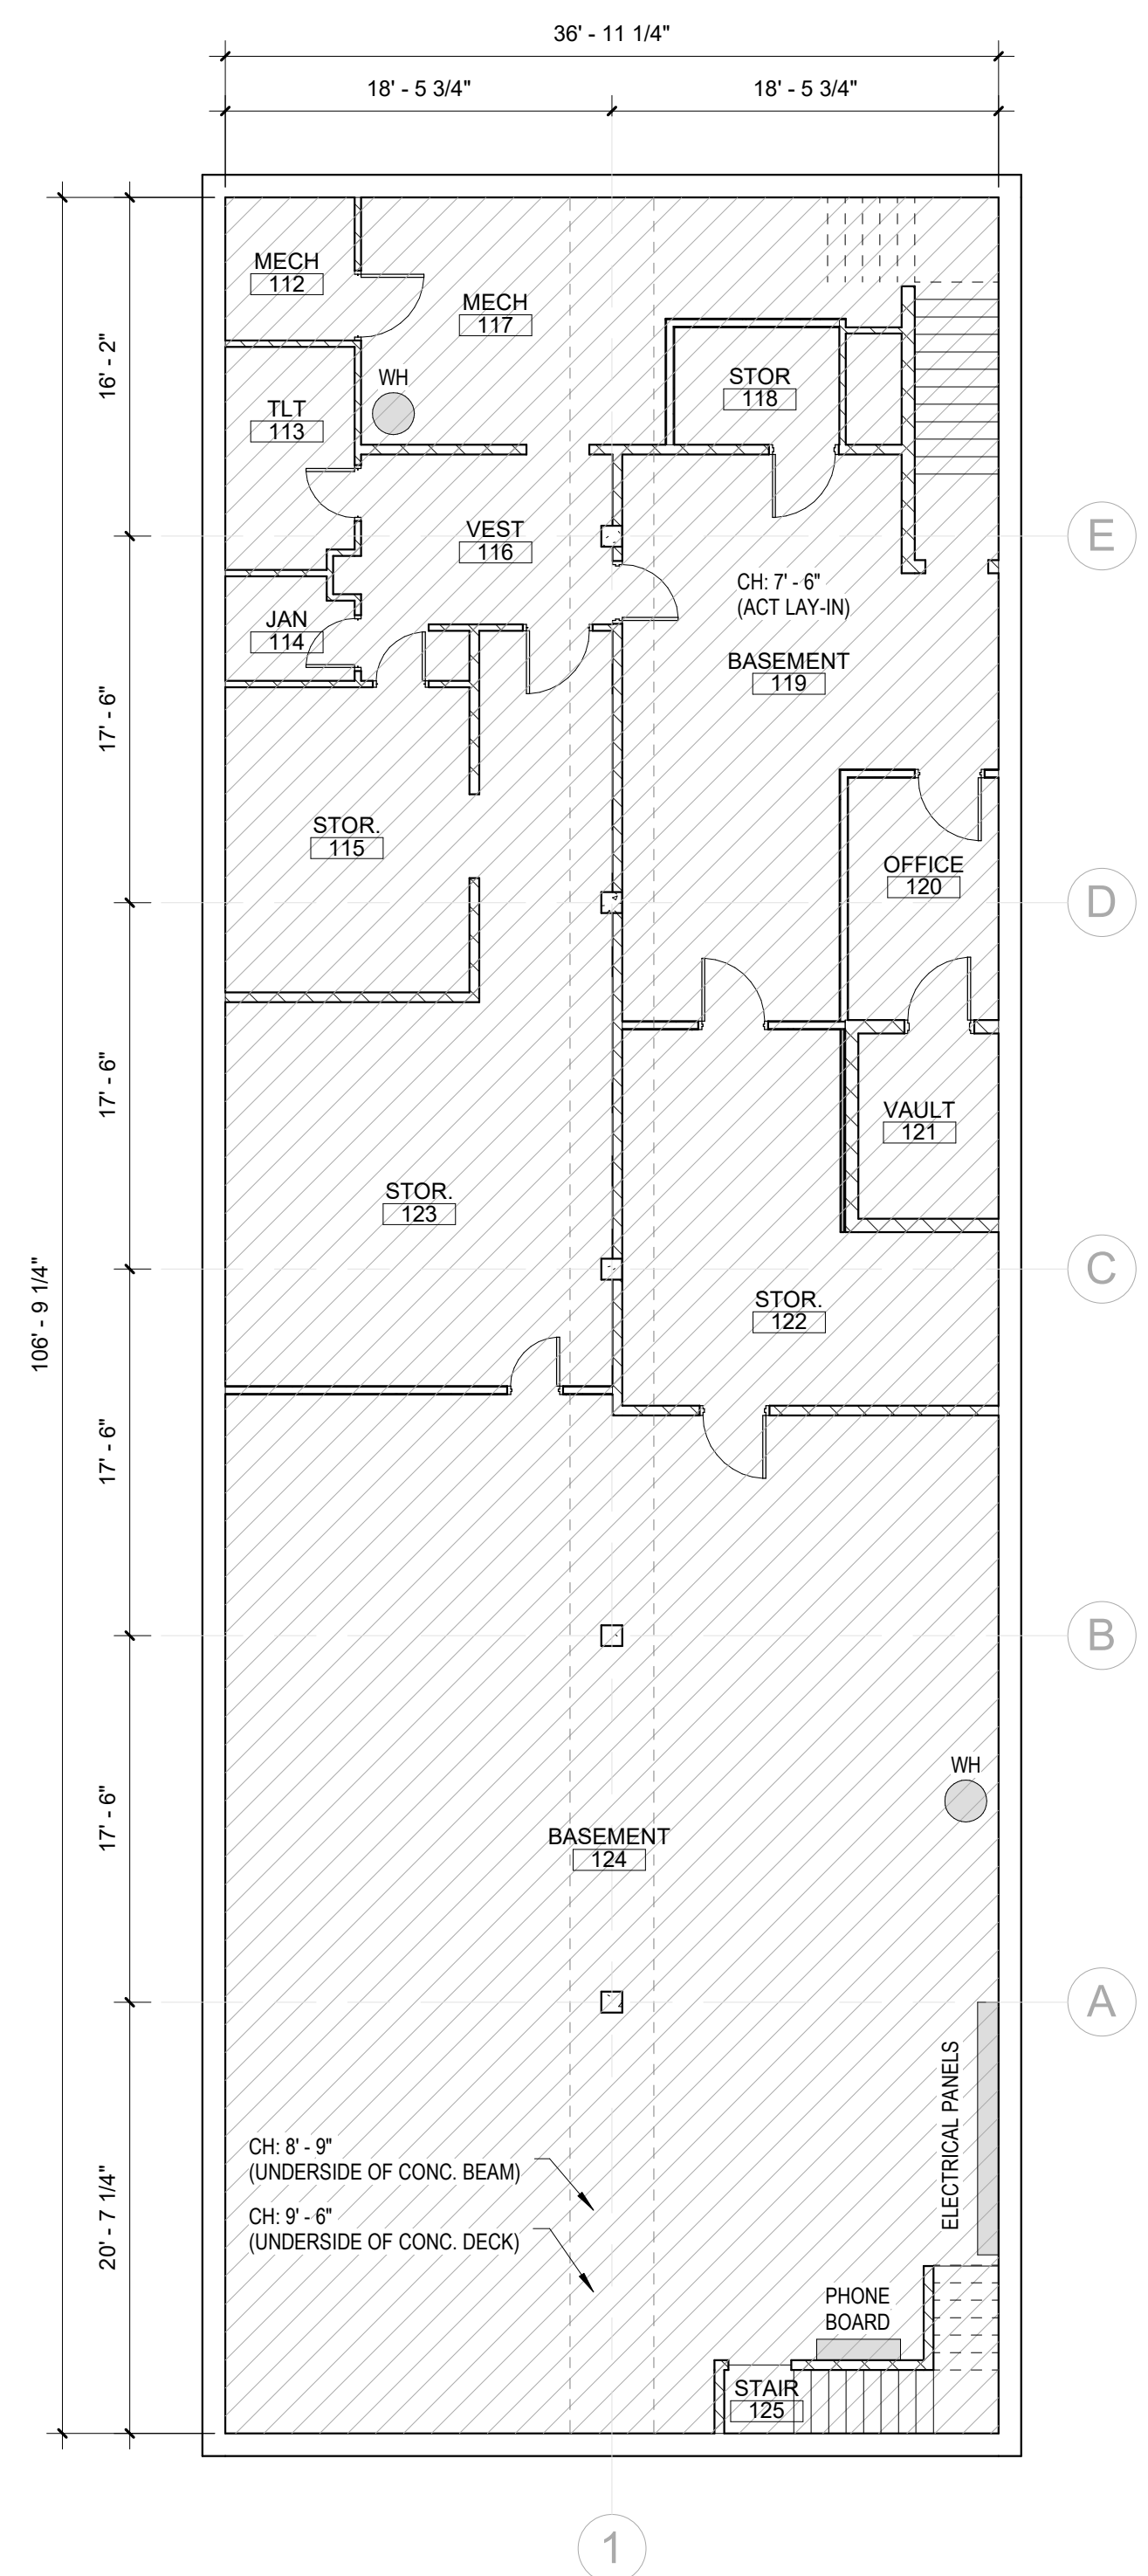

1 3,944 SF (INTERIOR FACE OF CONCRETE BASEMENT WALLS)

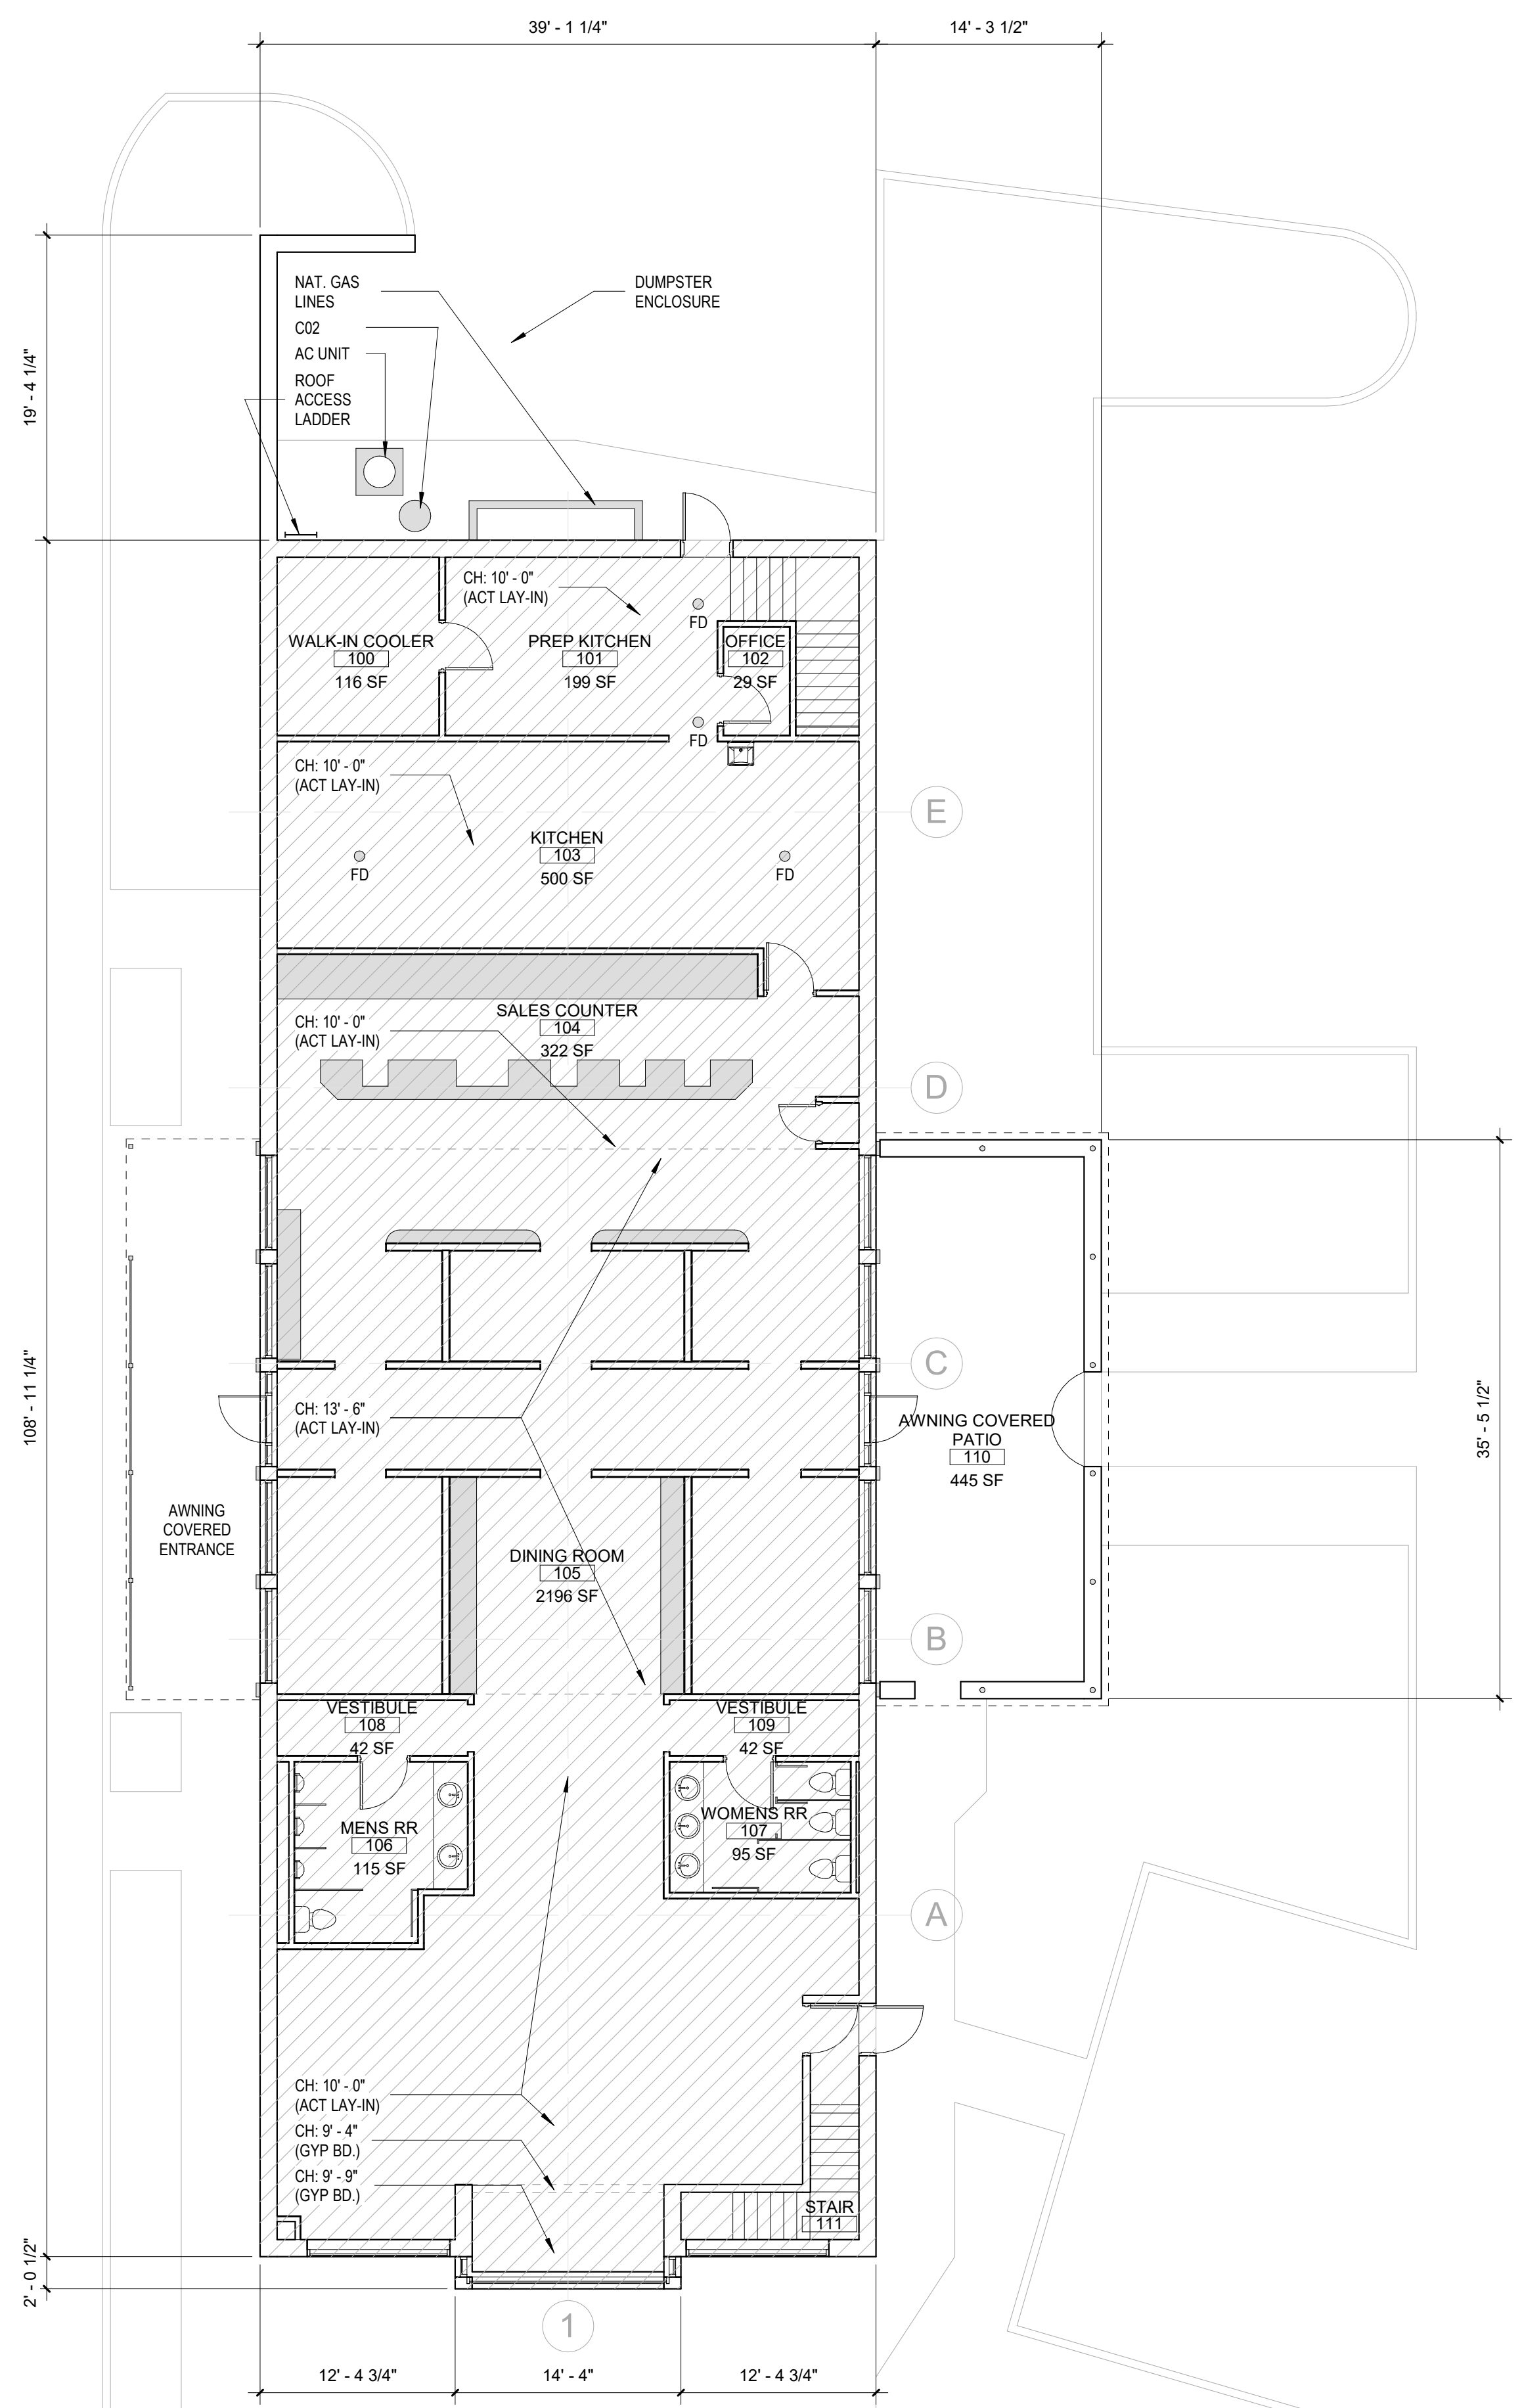

2 4,289 SF (EXTERIOR FACE OF PERIMETER WALLS)

1 LEVEL BASEMENT
 1/8" = 1'-0"

2 LEVEL GROUND
 1/8" = 1'-0"