

Seal

NOT FOR CONSTRUCTION

POPLAR PLAZA AS-BUILT

3476 PLAZA AVE. STE. 102
MEMPHIS, TN 38111


© 2022 UrbanARCH Associates, P.C.
No part of this work covered by the copyright hereon may be reproduced or copied in any form or by any means (graphic, electronic, mechanical, or photocopying) without the express written permission of UrbanARCH Associates, P.C. The use of these documents without the express written permission of UrbanARCH Associates, P.C. is illegal and a violation of federal copyright laws.

Revisions:

Project No: 22009
Issued For: AS-BUILT / MARKETING
Date: 02/22/2022

AS-BUILT PLAN

A-101

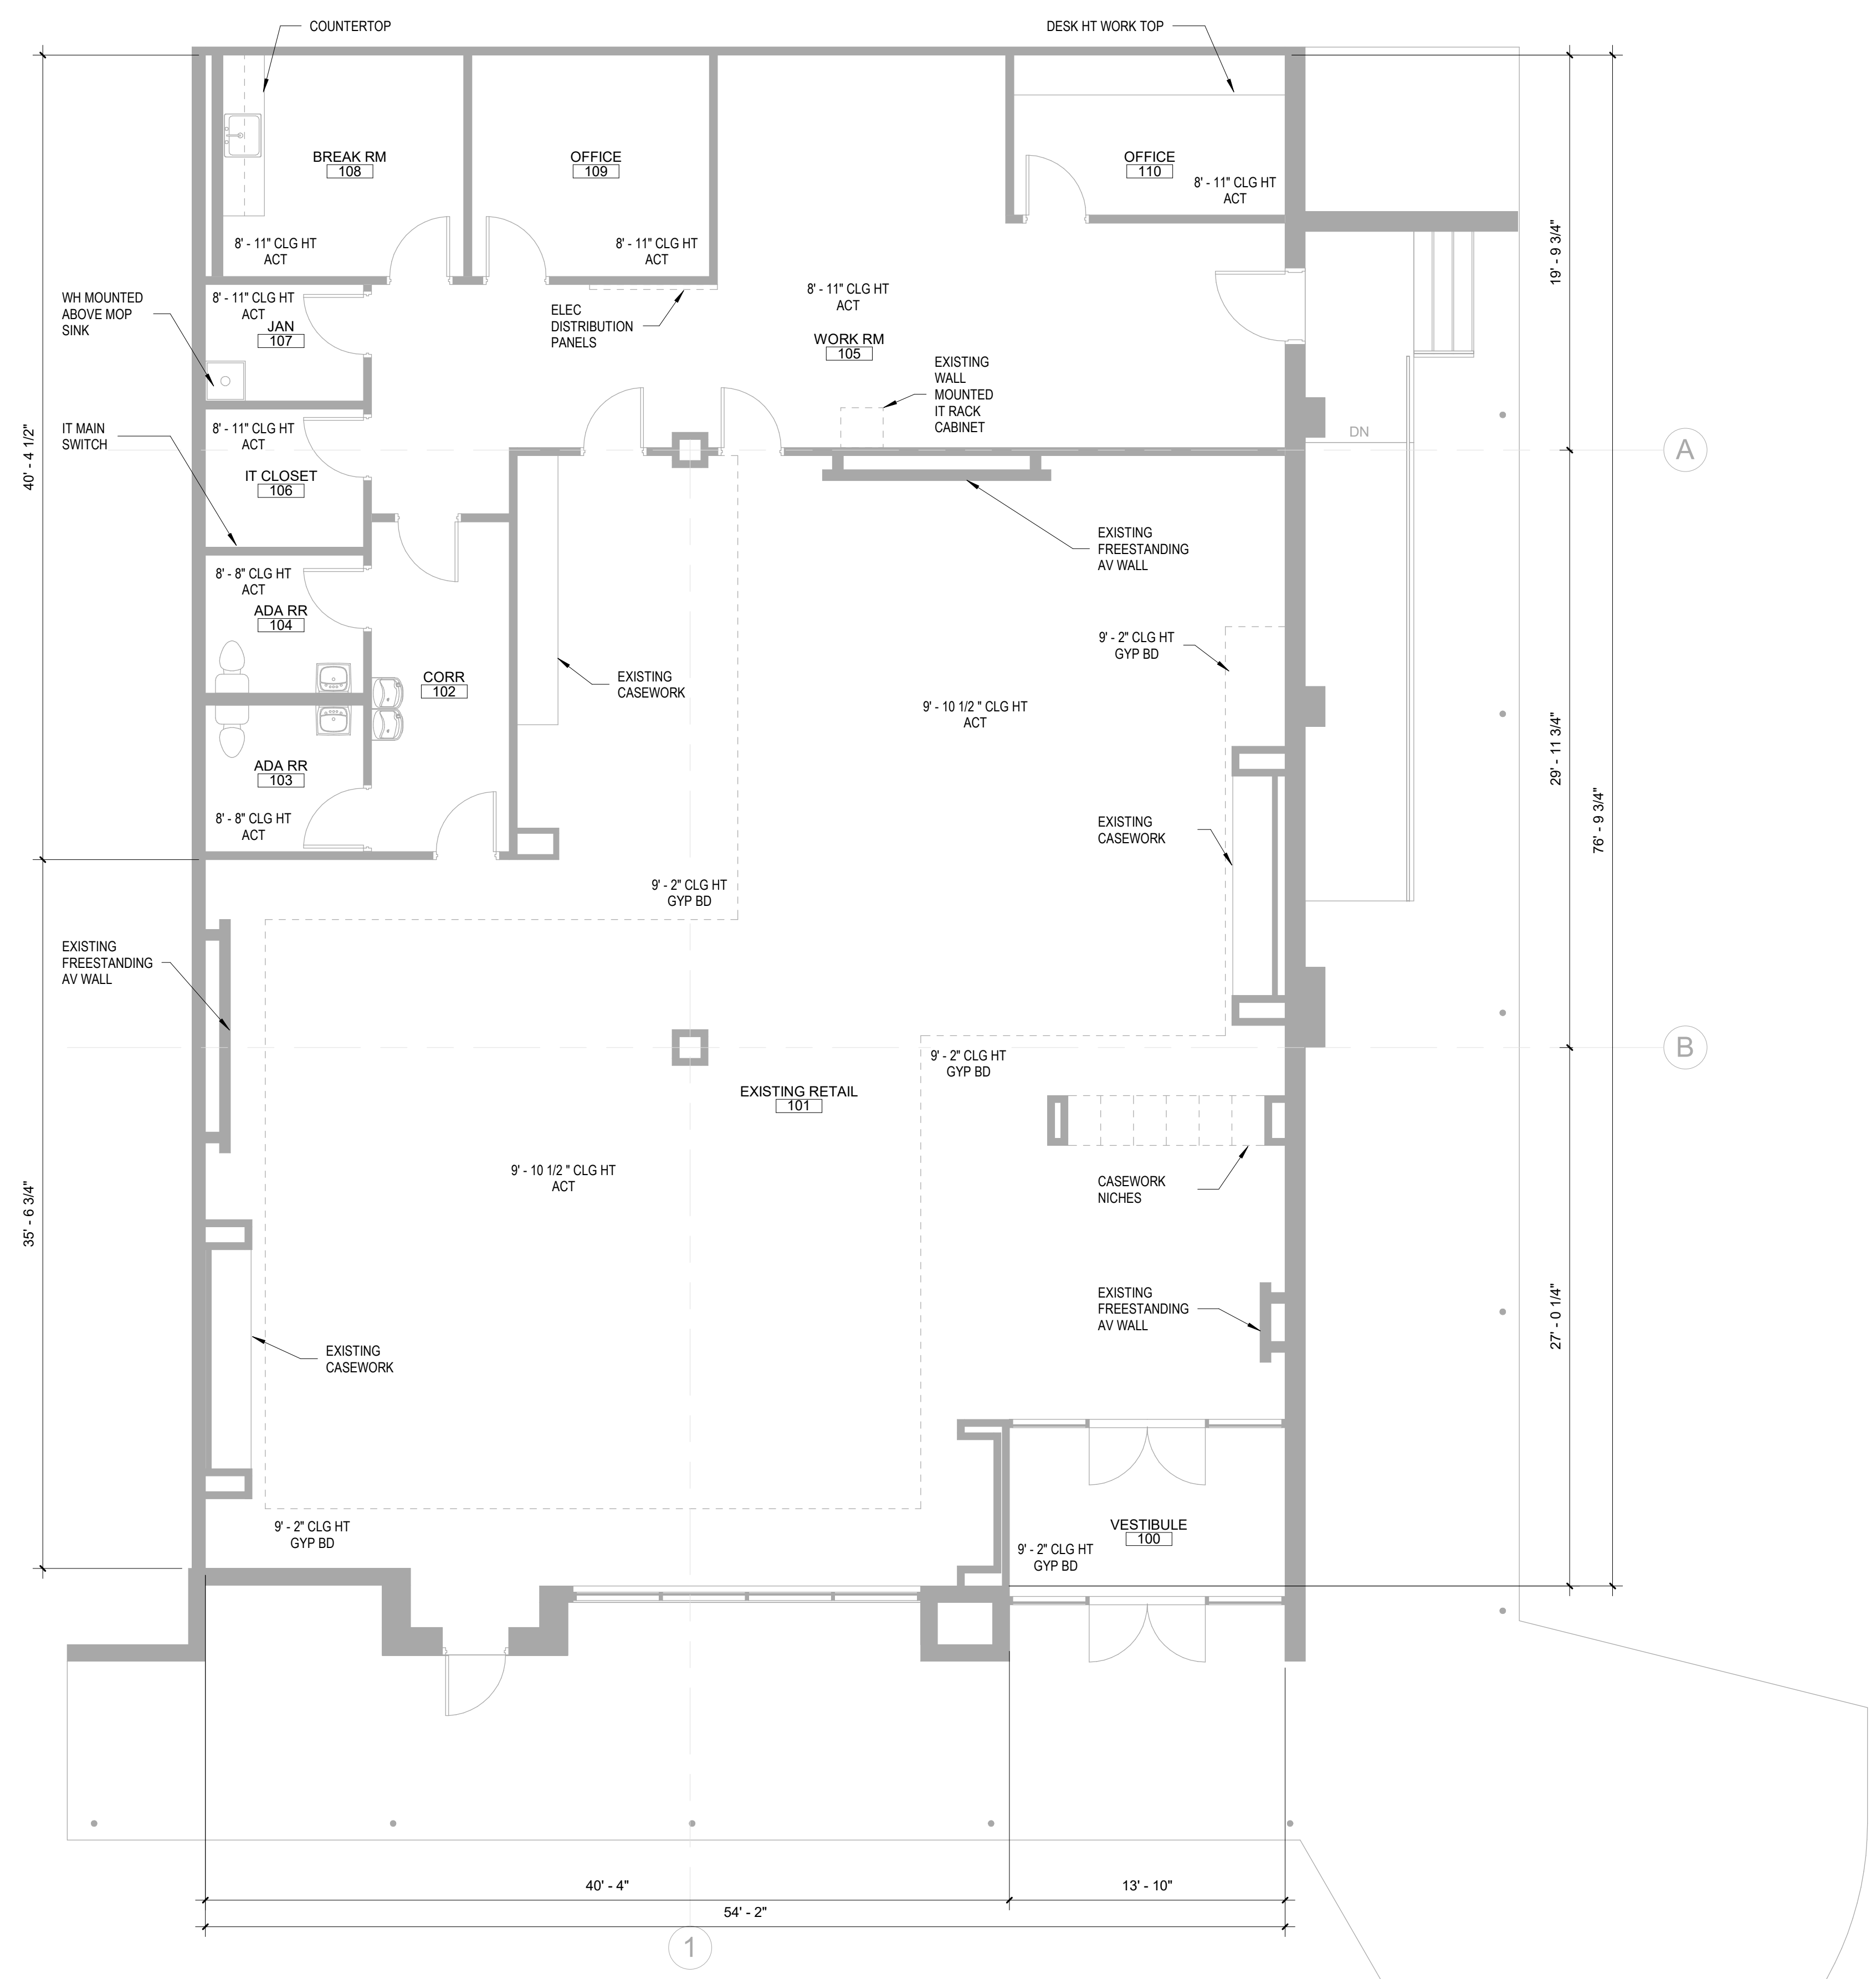

EXISTING APPROX. BOMA AREA = 4,362 SF (OUTSIDE FACE OF EXTERIOR WALLS, CENTER OF TENANT DEMISING WALLS)

1 LEVEL 1 - AS-BUILT
3/16" = 1'-0"