

**Urban
ARCH**
associates, p.c

498 SOUTH MAIN
MEMPHIS, TENNESSEE 38103
P 901.578.7173 / F 901.578.5223
www.uarch.com

Seal

NOT FOR
CONSTRUCTION

Consultants:

**TUESDAY MORNING
AS-BUILT**
45 SOUTH HIGHLAND

Revisions:

© 2017 UrbanArch Associates, P.C.
No part of this work covered by the copyright hereon
may be reproduced or copied in any form or by any
means (graphic, electronic, mechanical, or
photocopying) without the express written
permission
of UrbanArch Associates, P.C. The use of these
documents without the express written permission
of UrbanArch Associates, P.C. is illegal and a violation
of federal copyright laws.

Project No: 18005

Issued For: REVIEW ONLY

Date: 2/23/18

BASEMENT AS-BUILT
FLOOR PLAN 1/4"


A-100E

4

3

2

1

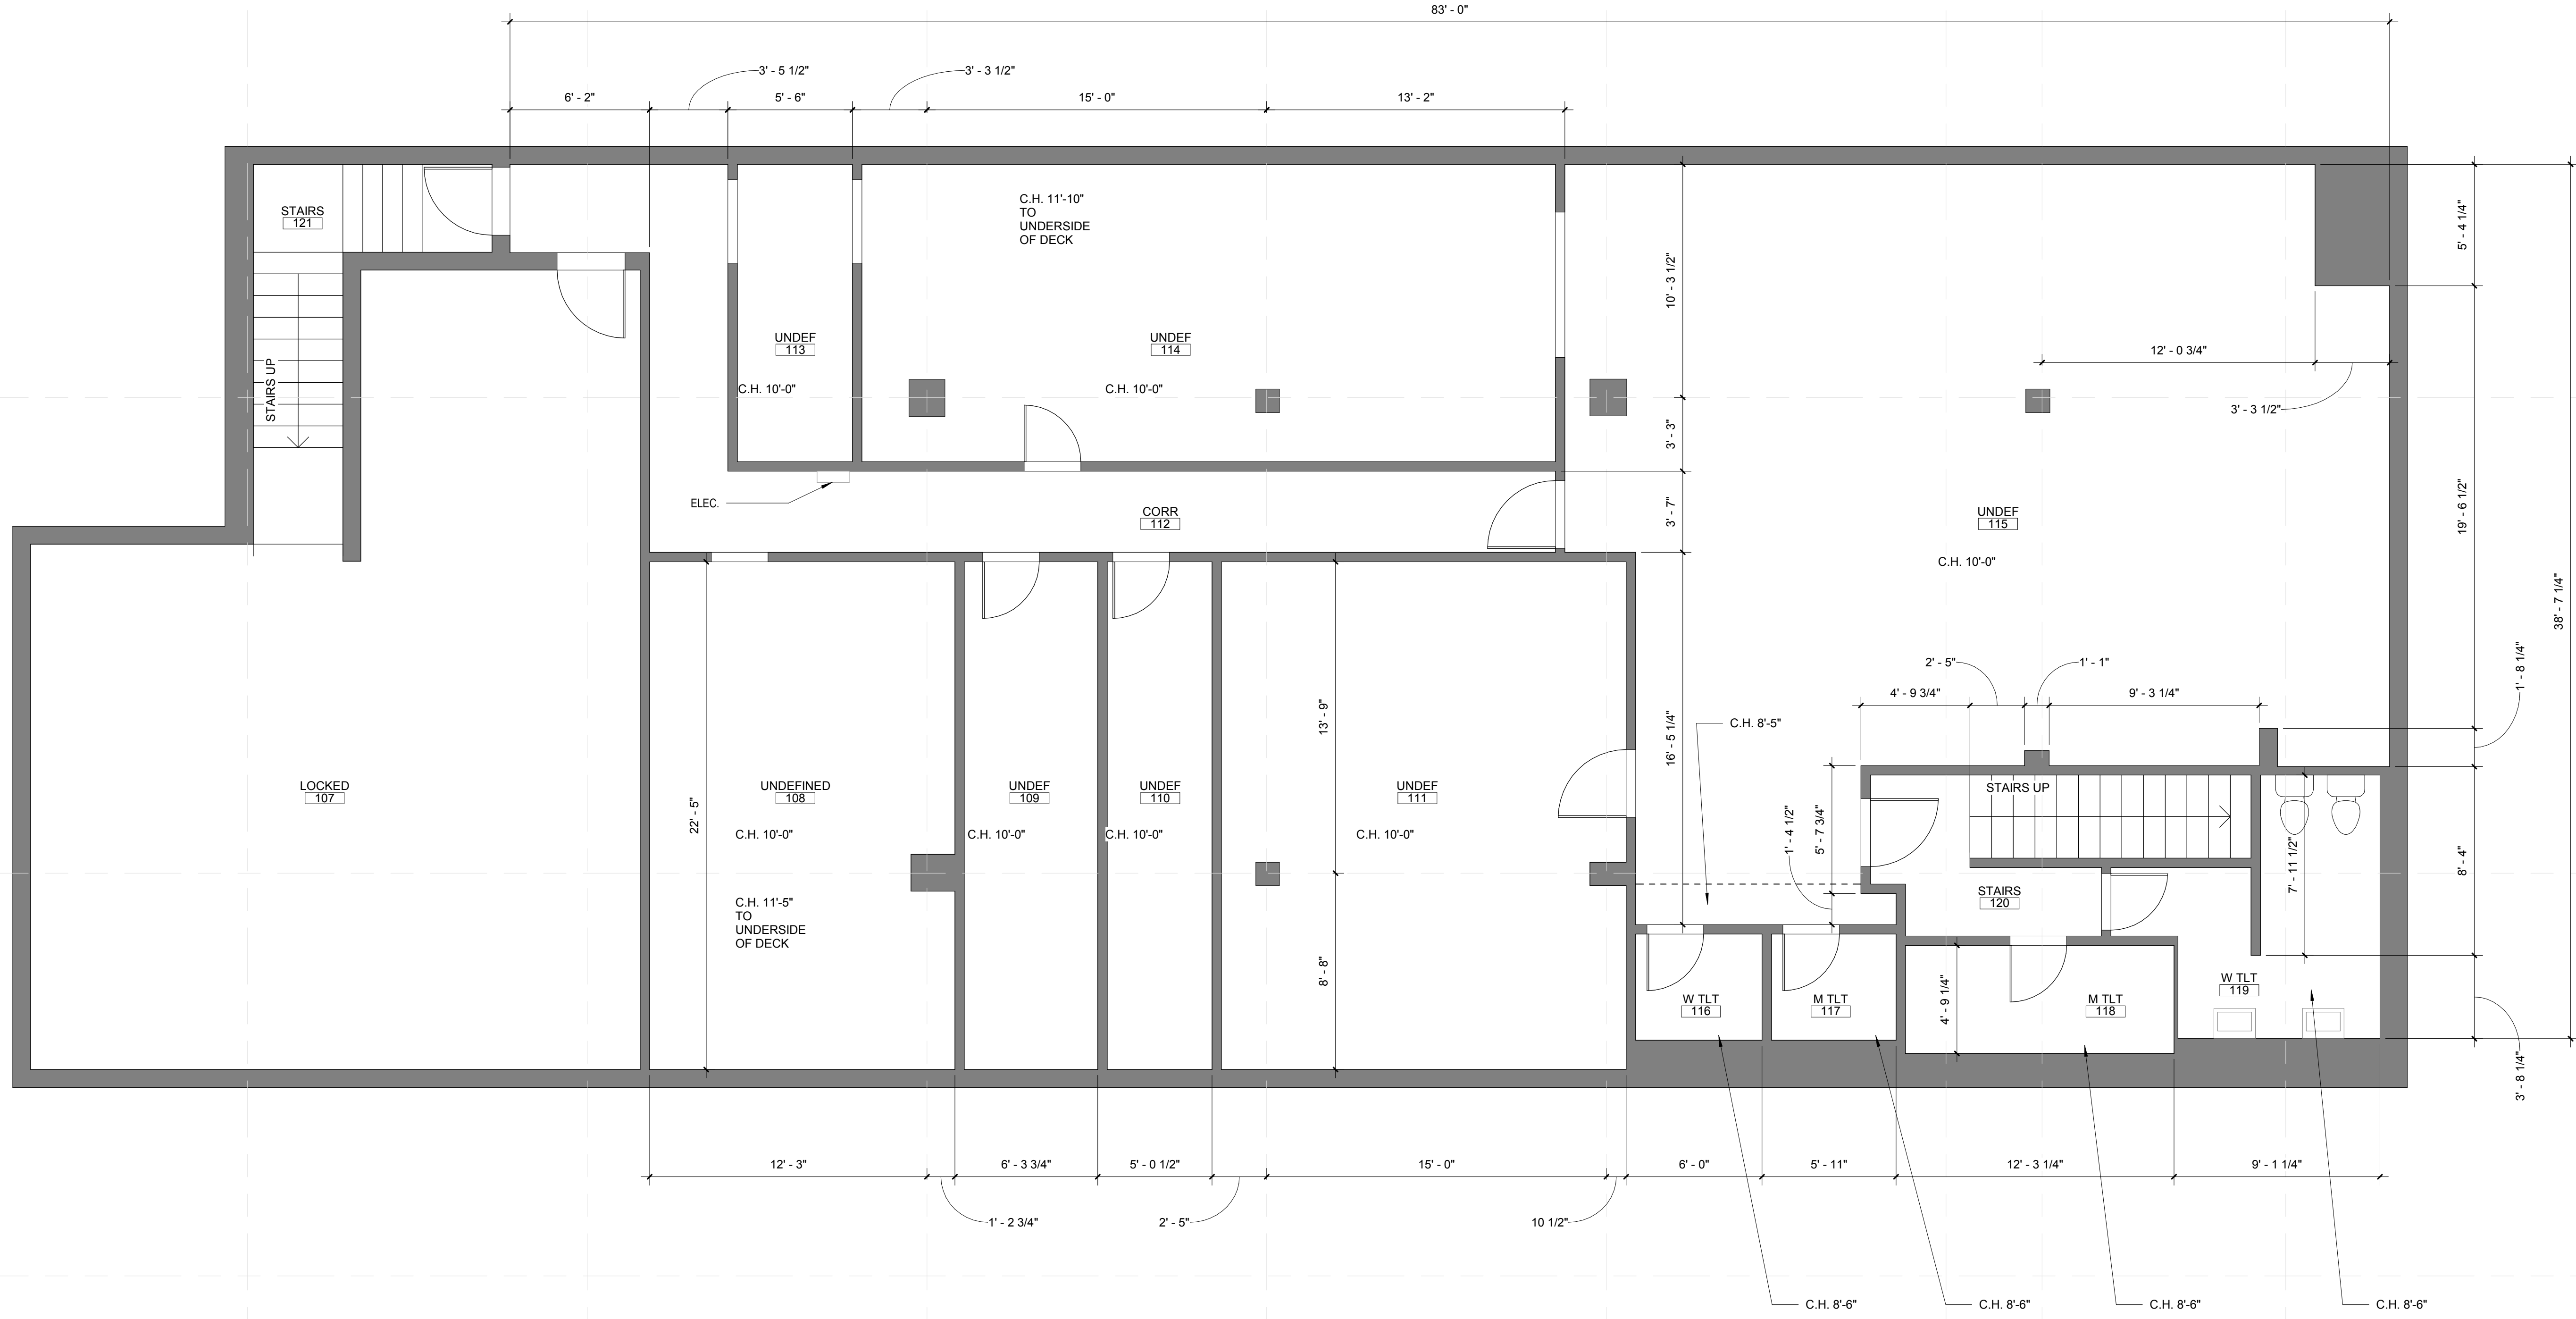

1 BASEMENT LEVEL - AS-BUILT PLAN

1/4" = 1'-0"

Seal

NOT FOR CONSTRUCTION

Consultants:


TUESDAY MORNING AS-BUILT
 45 SOUTH HIGHLAND

Revisions:

© 2017 UrbanArch Associates, P.C.
 No part of this work covered by the copyright herein may be reproduced or copied in any form or by any means (graphic, electronic, mechanical, or photocopying) without the express written permission of UrbanArch Associates, P.C. The use of these documents without the express written permission of UrbanArch Associates, P.C. is illegal and a violation of federal copyright laws.

Project No: 18005
 Issued For: REVIEW ONLY
 Date: 2/23/18

LEVEL 1 AS-BUILT FLOOR PLAN 1/4"
A-101E

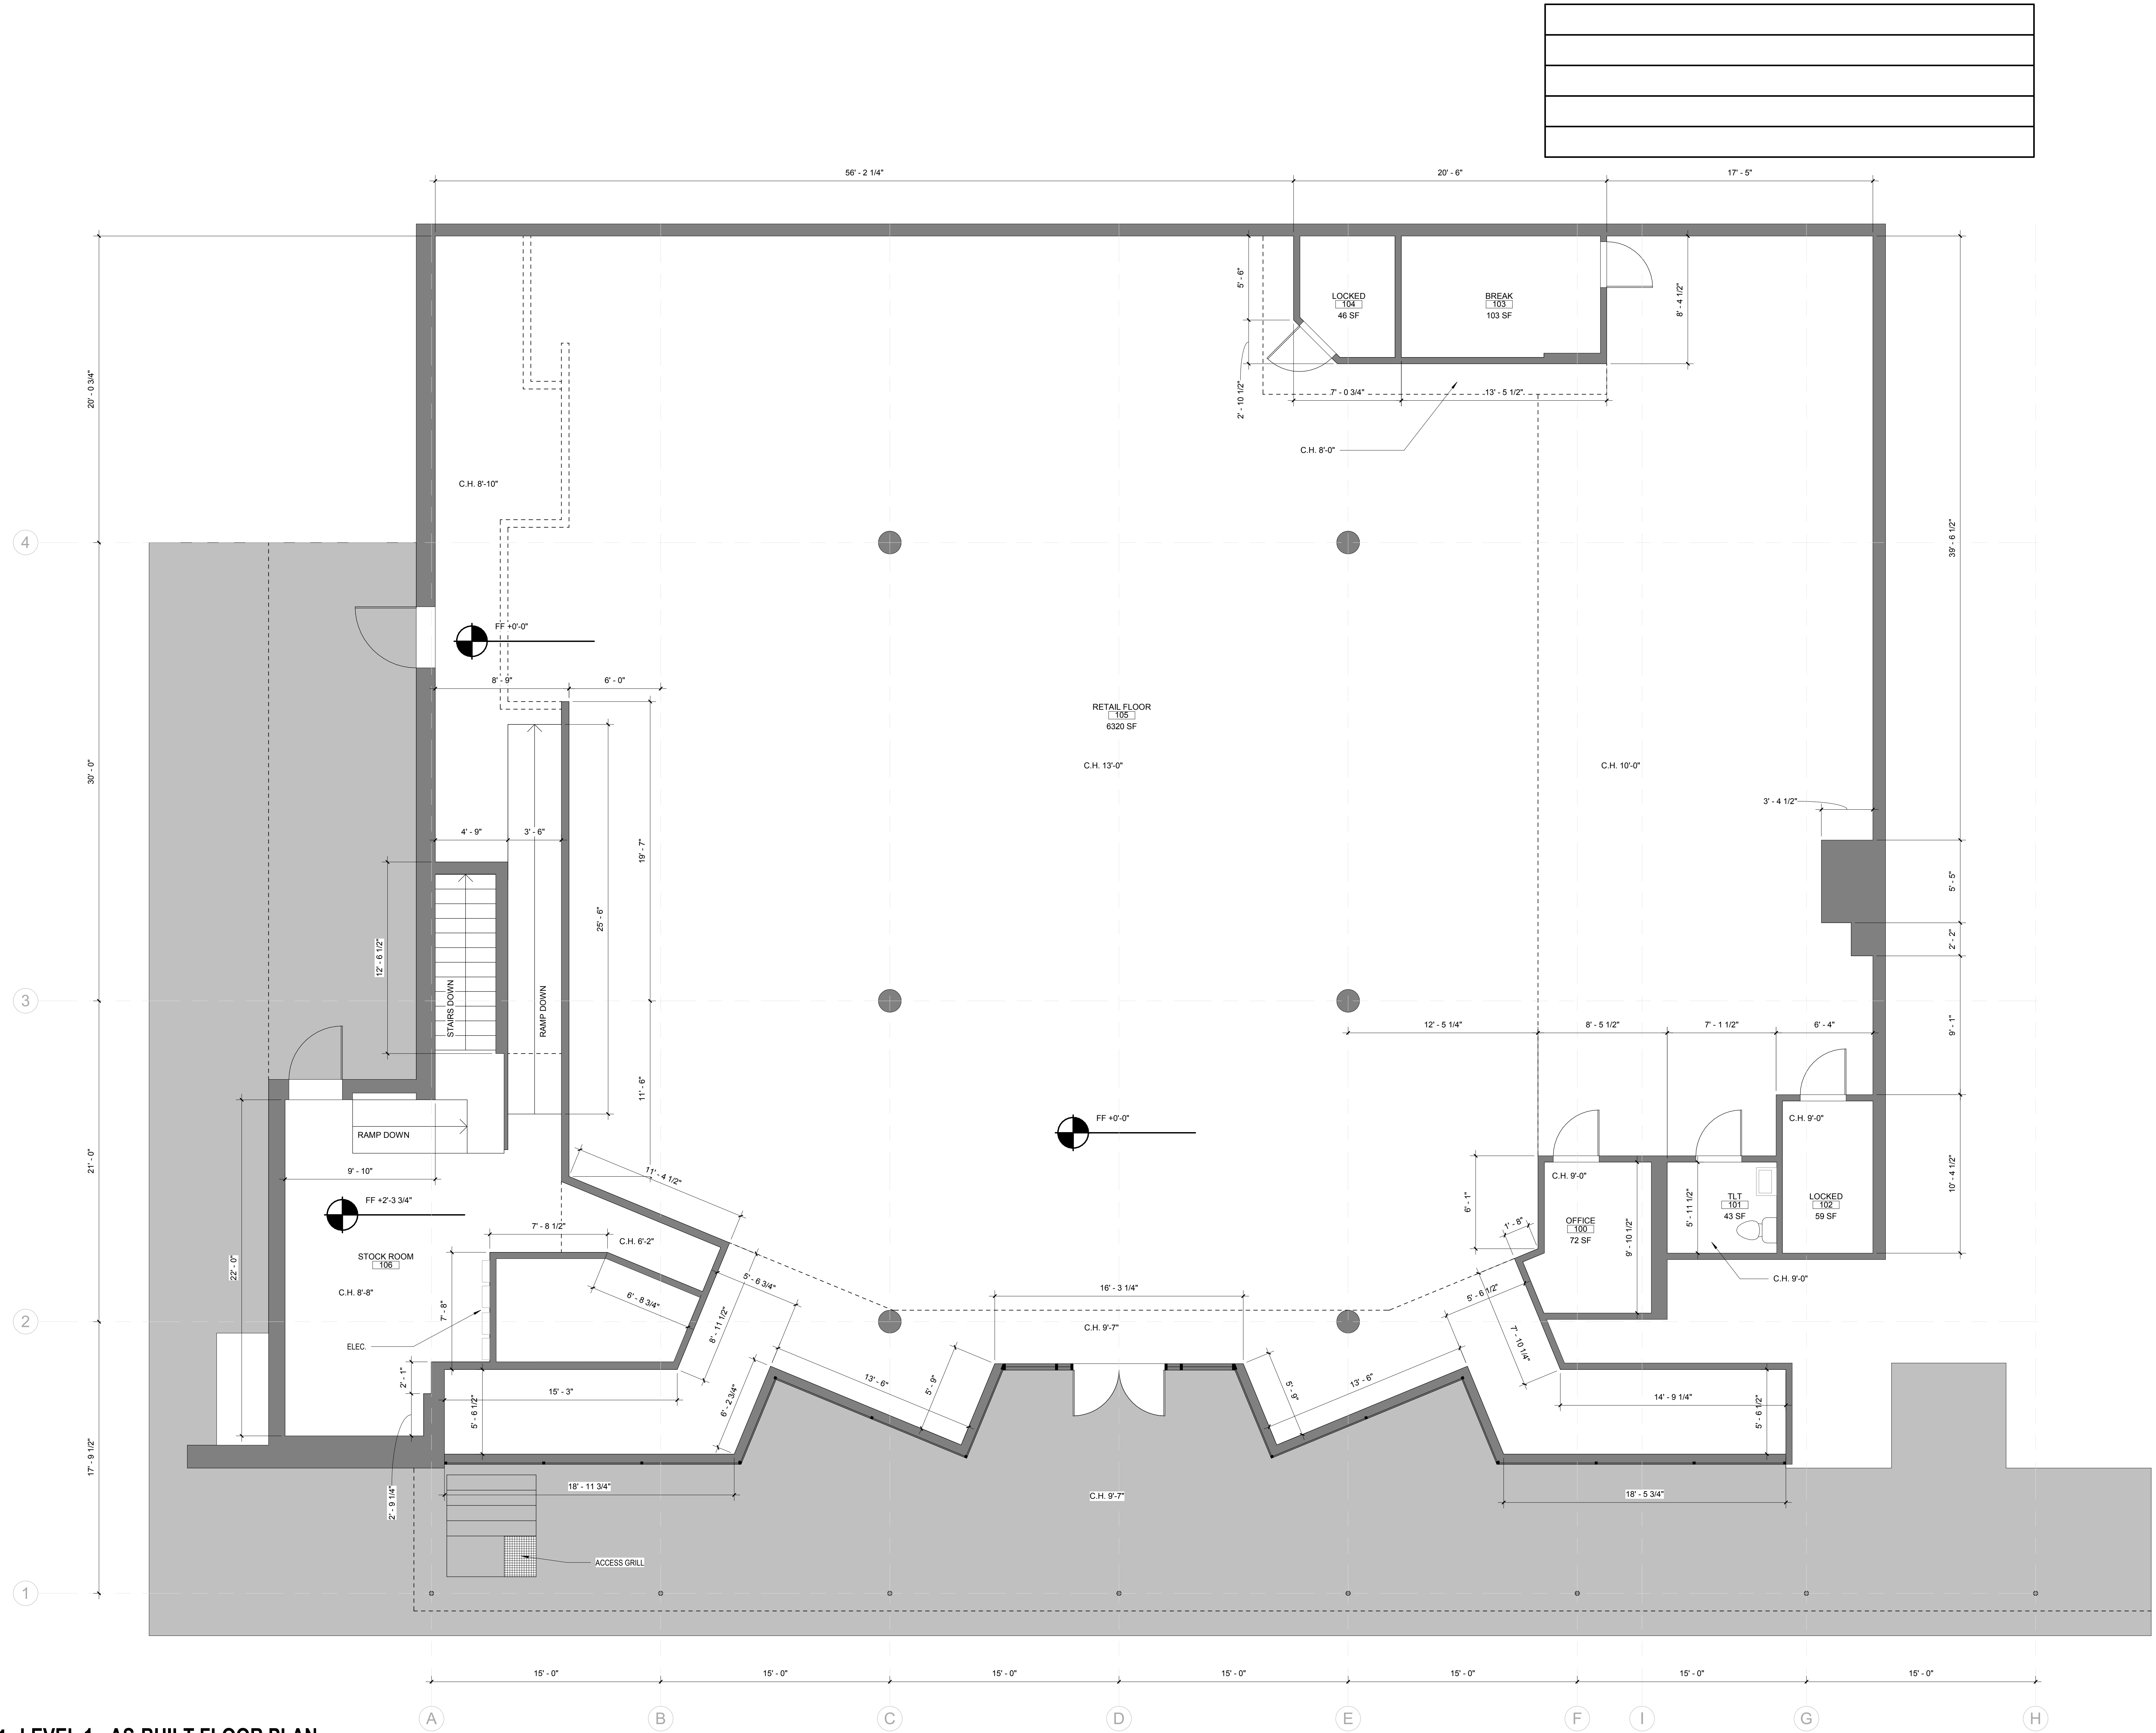

1 LEVEL 1 - AS-BUILT FLOOR PLAN
 1/4" = 1'-0"